LABOR AND MATERIALS

1	Copper / ~~Lead~~ Connection	3/4"	$ 1.31
1	Curb — Cock / Valve / ~~T. S. & V.~~	3/4 in.	$ 1.75
1	Service box — Short 3½ x 4½ / Long 4½ x 5½ / ~~Buff or Rdway~~		$ 1.60
25	Ft. 3/4 in. — Copper / ~~G. I.~~ / ~~C. I.~~ Pipe at 18		$ 4.50
	Nipples in. at		$
	Bushings to in. at		$
	Red'g / Inc'g Coupl'gs to in. at		$
	Union in. at		$
	Meter in. at		$
	Lead Joints at		$
	Compound Joints at		$
	Maintenance Foreman		$
7/12	Hrs. Water Maint. Man—1 at 62½		$ .44
9	Hrs. Water Maint. Man—2 at 45		$
	Hrs. Garage Foreman at		$
	Hrs. Labor— at		$
	Hrs. Compressor at		$
	Compensation Ins. at $ per C		$ .14
	Trucking		$ 1.00
	Pav't Patch		$ None
	Top by Hessel		$
			$
			$
	O'head		$
			$ 14.79

89-1940

Fourth ST St. / ~~Pl.~~ / Ave. No. 83

Name of Owner

Jos. Langdon

Lot Top made in

Labor and Mat'l. Report July 17 1940

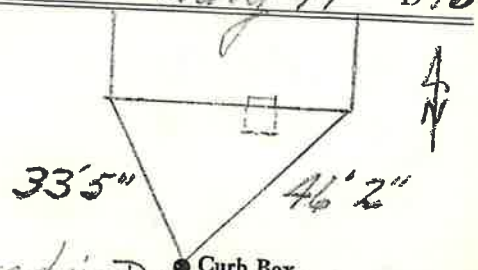

Measured in Dec 16-40

6" C.I. Main

Elev. of Main at tap 5'

Gate at

Gate at

Curb Box

LSM—5C—3-10-61