LABOR AND MATERIALS

1	Copper / ~~Lead~~ Connection 3/4	$ 1.31
1	Curb Cock / ~~Valve~~ / ~~T. S. & V.~~ 3/4 in.	$ 1.75
1	Service Box Old returned Short 3½x4½ / Long 4½x5½ / Buff. or Rdway	$ 1.60
9	Ft. 3/4 in. Copper / ~~Galv Iron~~ / ~~Cast Iron~~ Pipe at 18	$ 1.62
	Nipples ____ in. at	$
	Bushings ____ to ____ in. at	$
	Red'g / Inc'g Couplings ____ to ____ in. at	$
	Union ____ in. at	$
	Meter ____ in. at	$
	Lead Joints at	$
	Leadite Joints at	$
	Hrs. Foreman at	$
	Hrs. Chauffeur at	$
1/4	Hrs. Tapper at .62½	$ .16
	Hrs. Labor at	$
3½	Hrs. Labor at .45	$ 1.58
	Hrs. Compressor at	$
	Compensation Ins.	$ .06
	Trucking	$ 1.—
	Builders Use of Water no patch E 4r	$
	Tap by Hessel	$
		$
		$
		$
		$ 9.08

8 0 - - 1940

St. / ~~Pl.~~ / ~~Ave.~~ No. 84 Fourth Ext

Name of Owner Thomas

Labor and Mat'l. Report July 15 1940

Tap in center of 50' lot

see below.

● Curb Box

6 Main — Elev. of Main at tap 15

Gate at ● — ● Gate at
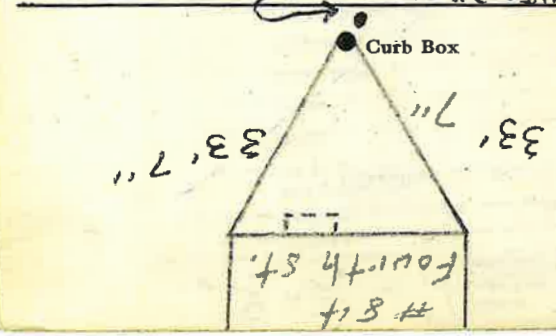
TAX ID # 309.11-12-12