LABOR AND MATERIALS

1 ~~Copper~~ ~~Lead~~ Connection 3/4 $

1 Curb ~~Cock~~ ~~Valve~~ ~~T. S. & V.~~ 3/4 in. $

Service box Old returned ~~Short 3½ x 4½~~ ~~Long 4½ x 5½~~ ~~Buff or Rdway~~ $

25 Ft. 3/4 in. ~~Copper~~ ~~G. I.~~ ~~C. I.~~ Pipe at $

Nipples in. at $

Bushings to in. at $

Red'g Inc'g Coupl'gs to in. at $

Union in. at $

Meter in. at $

Lead Joints at $

Compound Joints at $

Maintenance Foreman $

Hrs. Water Maint. Man—1 at $

Hrs. Water Maint. Man—2 at $

Hrs. Garage Foreman at $

Hrs. Labor— at $

Hrs. Compressor at $

Compensation Ins. at $ per C $

Trucking $

Pav't Patch $

$

$

$

O'head $

$

$

St.
Pl.
Ave. No. 95

Name of Owner

Freeway

Lot Top made in

Labor and Mat'l. Report July 1940

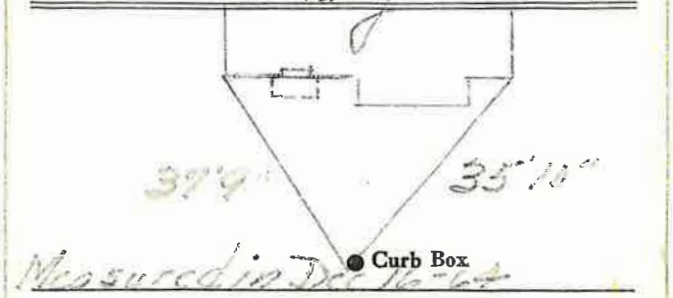

Measured in Dec 16-64

6" C.I. Main

Elev. of Main at tap 5"

Gate at ● ● Gate at

● Curb Box

LSM—8C—3-10-61

37' 9" 35' 10"

6" C.I. 5"