LABOR AND MATERIALS

1	Copper ~~Lead~~ Connection	3/4	$ 2.87
1	Curb { Cock ~~Valve~~ ~~T. S. & V.~~ }	3/4 in.	$ 3.62
1	Service Box Old returned { ~~Short 3⅛x4⅜~~ Long 4½x5¼ ~~Buff or Rdway~~ }		$ 4.68
8	Ft. 3/4 in. { Copper ~~Galv Iron~~ ~~Cast Iron~~ } Pipe at 32		$ 3.56
	Nipples ... in. at		$
	Bushings ... to ... in. at		$
	Red'g Inc'g Couplings ... to ... in. at		$
	Union ... in. at		$
	Meter ... in. at		$
	Lead Joints at		$
	Leadite Joints at		$
10	Hrs. Foreman at Wm. J.	1.07½	$ 10.70
	Hrs. Chauffeur at		$
	Hrs. Tapper at		$
24	Hrs. Labor at	91	$ 23.66
	Hrs. Labor at		$
3	Hrs. Compressor at	1.20	$ 3.60
	Compensation Ins.	2.18	$ .74
	Trucking		$ 3.00
	Builders Use of Water Patch		$ 1.45
	Tap by Worsinski		$
			$
			$
			$
			$ 69.79

61

St: ~~Pl.~~ 12

Fradella Ave. No. 11

Name of Owner

Jessica Vio

Labor and Mat'l. Report June 30 ~~SEP 6 1949~~ 1949

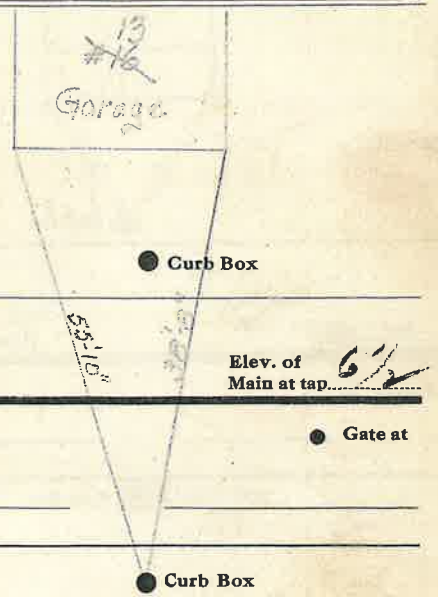

1 Main

Elev. of Main at tap 6½

Gate at

Gate at