LABOR AND MATERIALS

1	Copper ~~Lead~~ Connection 3/4	$ 1.35
1	Curb { Cock ~~Valve~~ ~~T. S. & V.~~ } 3/4 in.	$ 1.88
1	Service Box Old returned { Short 3½x4½ ~~Long 4½x5½~~ ~~Buff. or Rdway~~ }	$ 1.82
21 Ft. 3/4 in.	{ Copper ~~Galv Iron~~ ~~Cast Iron~~ } Pipe at 20	$ 4.20
	Nipples ____ in. at	$
	Bushings ____ to ____ in. at	$
	Red'g Inc'g Couplings ____ to ____ in. at	$
	Union ____ in. at	$
	Meter ____ in. at	$
	Lead Joints at	$
	Leadite Joints at	$
	Hrs. Foreman at	$
16	Hrs. Chauffeur at 68¾	$ 11.00
5	Hrs. Tapper at	$ 3.44
16	Hrs. Labor at 55	$ 8.80
	Hrs. Labor at	$
2	Hrs. Compressor at 92	$ 1.84
	Compensation Ins.	$ .71
	Trucking	$ 1.—
	Builders Use of Water Patch	$ 9.00
	Tap by Wasilewski	$
		$
		$
		$ 45.04

H.

18 1942

St. 17
Pl.
Fredella Ave. No. 12

Name of Owner

Flouidore

Labor and Mat'l. Report Apr 29 19 42

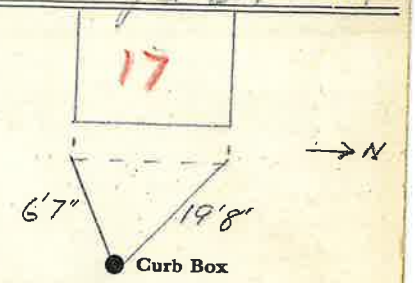

6" Main

Elev. of Main at tap 6'

Gate at

Gate at

Curb Box