LABOR AND MATERIALS

___ Copper Lead	Connection	$
1 Curb	Cock ~~Valve~~ ~~T. S. & V.~~	___ in. $
1 Service box	Short 3½ x 4½ / Long 4½ x 5½ / Buff or Rdway	
	Old returned	$
6 Ft. 3/4 in.	~~Copper~~ ~~G. I.~~ ~~C. I.~~ Pipe at	$
___	Nipples ___ in. at	$
___	Bushings ___ to ___ in. at	$
___ Red'g / ___ Inc'g	Coupl'gs ___ to ___ in. at	$
___	Union ___ in. at	$
___	Meter ___ in. at	$
___	Lead Joints at	$
___	Compound Joints at	$
___	Maintenance Foreman	$
___	Hrs. Water Maint. Man—1 at	$
___	Hrs. Water Maint. Man—2 at	$
___	Hrs. Garage Foreman at	$
___	Hrs. Labor— at	$
___	Hrs. Compressor at	$
___	Compensation Ins. at $ ___ per C	$
___	Trucking	$
___	Pav't Patch	$
		$
	Measured in by	$
	Farmer & Donovan	$
	10-14-68	
___	O'head	$
		$

By Busch
Lynch
Mitchell
12/24/84

St. ~~Pl.~~ 6
Gage Ave. No. 2

Name of Owner

Lucy E Hunsinger

Measured in

Labor and ~~Mat'l.~~ Report Oct. 14 1968.

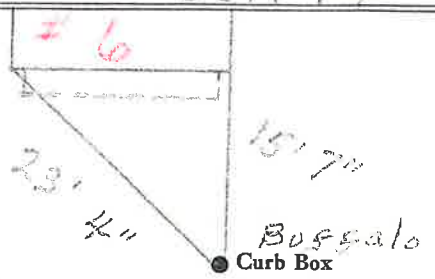

4 Main

Elev. of Main at tap 25'

Gate at ●

● Gate at

● Curb Box

LSM—5C—3-10-61