LABOR AND MATERIALS

Copper Lead } Connection ____ $____

Curb { Cock / Valve / T. S. & V. } ____ in. ____ $____

Service box Old returned { Short 3½ x 4½ / Long 4½ x 5½ } ____ $____

22' 10" Ft. 3/4 in. { Copper / ~~C. I.~~ / ~~C. I.~~ } Pipe at ____ $____

____ Nipples ____ in. at ____ $____

____ Bushings ____ to ____ in. at ____ $____

Red'g Inc'g } Coupl'gs ____ to ____ in. at ____ $____

____ Union ____ in. at ____ $____

____ Meter ____ in. at ____ $____

____ ____ $____

____ Compound Joints at ____ $____

____ Maintenance Foreman ____ $____

____ Hrs. Water Maint. Man—1 at ____ $____

____ Hrs. Water Maint. Man—2 at ____ $____

____ Hrs. Garage Foreman ____ at ____ $____

____ Hrs. Labor— ____ at ____ $____

____ Hrs. Compressor at ____ $____

____ $____

____ Trucking ____ $____

____ Pav't Patch ____ $____

____ $____

____ $____

____ $____

____ ____ $____

$____

St. Pl. Ave. No. 28

GARFIELD

Name of Owner

Labor and Mat'l. Report 1970

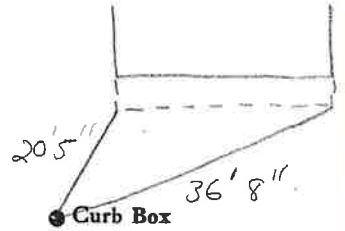

____ Main

Elev. of Main at tap ____

Gate at ●

● Gate at

● Curb Box

LSM—5C—6-1-67

Labor and Materials

1	Lead Connection ¾	$ 2.69
1	Curb Cock ¾	$ 1.76
1	Service Box Old returned { Short 3½ x 4½ / ~~Long 4½ x 6½~~ / Buffalo }	$ 1.29
21	Ft. 1 in. G. I. Pipe at	$ 4.19
	Nipples ..... in. at	$
	Bushings ..... to ..... in. at	$
	Red'g Coup .... to .... in. at	$
	Inc'g Coup .... to .... in. at	$
	Union .... in. at	$
	Meter .... in. at	$
	Cu. Yds. Br. Stone at	$
	Cu. Yds. Sand at	$
	Bags Cement at	$
	Paving Brick { Mack / Red / Asphalt } at	$
2	Hrs. Foreman at	$ 1.25
10	Hrs. Common Labor at	$ 4.06
	Hrs. Mason at	$
	Hrs. at	$
	Hrs. at	$
1	Builders' Use of Water	$ 1.50
1	truck at	$ 1.20
Comp. Gas	at	$ .14
	at	$
	at	$
	Total	$ 12.78

Sept. 10

Labor and Material Report 1924

28 Garfield

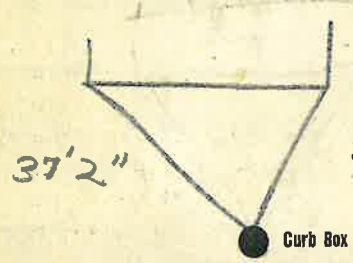

6 Main — Elev. of Main at tap 4

Gate at ● — ● Gate at

● Curb Box