LABOR AND MATERIALS

1	Copper / ~~Lead~~ Connection 3/4"	$ 2.60
1	Curb — Cock / Valve / ~~T. S. & V.~~ 3/4 in.	$ 2.27
1	Service box — ~~Old returned~~ — Short 3½ x 4½ / Long 4½ x 5½ / Buff or Rdway	$ 1.38
8	Ft. 3/4 in. — Copper / ~~G.I.~~ / ~~C.I.~~ Pipe at	$ 1.44
	Nipples in. at	$
	Bushings to in. at	$
	Red'g / Inc'g Coupl'gs to in. at	$
	Union in. at	$
	Meter in. at	$
	Lead Joints at	$
	Compound Joints at	$
3/4 hr.	Maintenance Foreman	$ .47
3/4	Hrs. Water Maint. Man—1 at	$ .38
	Hrs. Water Maint. Man—2 at	$
	Hrs. Garage Foreman at	$
6½	Hrs. Labor— at	$ 2.93
	Hrs. Compressor at	$
	Compensation Ins. at $ per C	$ .12
	Trucking	$ 1.00
	Pav't Patch	$
		$
		$
		$
	O'head	$
		$ 12.59

V 31 - 211

~~#3~~ ~~#9~~

St. Garfield Pl. Ave. No. 55

Name of Owner

Labor and Mat'l. Report Apr. 23 19 31

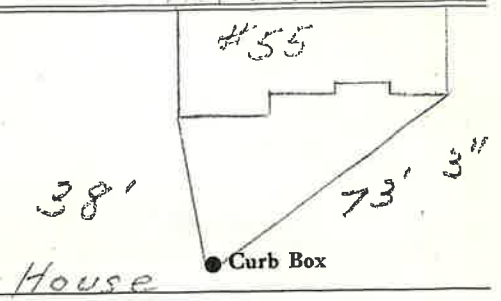

6" Main

Elev. of Main at tap 5'

Gate at ● ● Gate at

Lot Tap 1931 ● Curb Box

New House 1959 built on 2 Lots #53-55

See card for #53

LSM—5C—2-5 56