LABOR AND MATERIALS

Copper Lead } Connection ..... $.....

Curb { Clock Valve T. S. & V. } ..... in. ..... $.....

Service box Old returned { Short 3½X4½ Long 4½X5½ Buff or Rdway } ..... $.....

10 Ft. 3/4 in. { Copper ~~Galv. Iron~~ Cast Iron } Pipe at ..... $.....

Nipples ..... in. at ..... $.....

Bushings ..... to ..... in. at ..... $.....

Red'g Inc'g } Couplings ..... to ..... in. at ..... $.....

Union ..... in. at ..... $.....

Meter ..... in. at ..... $.....

Lead Joints at ..... $.....

Compound Joints at ..... $.....

Hrs. Foreman at ..... $.....

Hrs. Chauffeur at ..... $.....

Hrs. Tapper at ..... $.....

Hrs. Labor at ..... $.....

Hrs. Labor at ..... $.....

Hrs. Compressor at ..... $.....

Compensation Ins. ..... $.....

Trucking ..... $.....

Builders Use of Water ..... $.....


..... $.....

..... $.....

..... $.....

$.....

Garfield St. ~~Pl.~~ ~~Ave.~~ No. 11

Name of Owner

Labor and Mat'l. Report Dec 11 1945

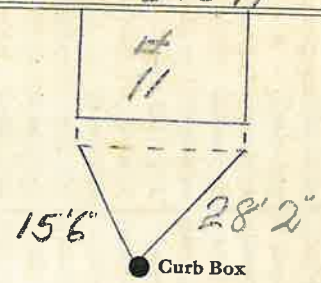

6" Main

Elev. of Main at tap 5'

Gate at ●

● Gate at

● Curb Box

LSM-SC-6-1-45