LABOR AND MATERIALS

1	Copper ~~Lead~~ Connection	$ 1.23
1	Curb { Cock / Valve / ~~T. S. & V.~~ } 3/4 in.	$ 1.68
1	Service Box ~~Old returned~~ { Short 3½x4½ / ~~Long 4½x5½~~ / ~~Buff. or Rdway~~ }	$ 1.54
11	Ft. 3/4 in. { Copper / ~~Galv Iron~~ / ~~Cast Iron~~ } Pipe at 17	$ 1.87
	Nipples ____ in. at	$
	Bushings ____ to ____ in. at	$
	Red'g / Inc'g Couplings ____ to ____ in. at	$
	Union ____ in. at	$
	Meter ____ in. at	$
	Lead Joints at	$
	Leadite Joints at	$
	Hrs. Foreman at	$
2	Hrs. Chauffeur at 62½	$ 1.25
4	Hrs. Tapper at "	$ 2.50
4	Hrs. Labor at 45	$ 1.80
	Hrs. Labor at	$
	Hrs. Compressor at	$
	Compensation Ins.	$ .17
	Trucking	$ 1.00
	Builders Use of Water Patch	$ 5.00
	Tapby Hesser	$
		$
		$
		$
		$ 18.04

5 7 - - 1939

St.
~~Pl.~~
~~Ave.~~ No. 50

Geer

Name of Owner

Nelson

Labor and Mat'l. Report Aug. 15 1939

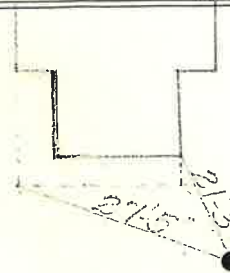

4" Main

Elev. of Main at tap 4'

Gate at ●

● Gate at

● Curb Box