LABOR AND MATERIALS

1	Copper ~~Lead~~ Connection 3/4	$ 1.23
1	Curb ~~Cock~~ ~~Valve~~ ~~T. S. & V.~~ 3/4 in.	$ 1.68
1	Service Box ~~Old returned~~ ~~Short 3½x4½~~ ~~Long 4½x5½~~ ~~Buff. or Rdway~~	$ 1.75
34 Ft. 3/4 in.	~~Copper~~ ~~Galv Iron~~ ~~Cast Iron~~ Pipe at 15	$ 5.10
	Nipples ____ in. at	$
	Bushings ____ to ____ in. at	$
	Red'g Inc'g Couplings ____ to ____ in. at	$
	Union ____ in. at	$
	Meter ____ in. at	$
	Lead Joints at	$
	Leadite Joints at	$
	Hrs. Foreman at	$
13	Hrs. Chauffeur at 62½	$ 8.13
	Hrs. Tapper at	$
16	Hrs. Labor at 45	$ 7.20
	Hrs. Labor at	$
2	Hrs. Compressor at $1.W	$ 2.63
	Compensation Ins.	$ .47
	Trucking	$ 1.00
	Builders Use of Water Patch	$ 18.00
Tap by Owner		$
		$
		$
		$ 47.19

7 5 - 1938

St. 468

Gl[illegible] Ave. No. 274

Name of Owner

D B Sprague

Labor and Mat'l. Report Aug 4 1938

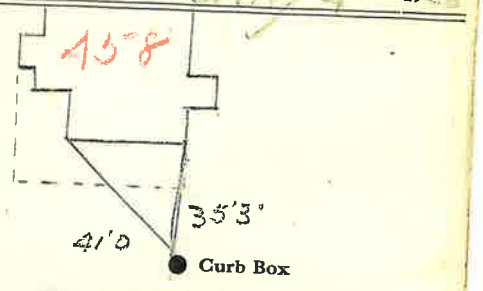

12 Main Elev. of Main at tap 4[illegible]

Gate at ● ● Gate at

● Curb Box

old shelf 55