LABOR AND MATERIALS

Copper Lead } Connection ..... $.....

Curb { Clock / Valve / T. S. & V. } ..... in. ..... $.....

Service box Old returned { Short 3⅛X4⅛ / Long 4⅛X5⅝ / Buff or Rdway } ..... $.....

.....Ft. ..... in. { Copper / Galv. Iron / Cast Iron } Pipe at ..... $.....

.....Nipples ..... in. at ..... $.....

.....Bushings ..... to ..... in. at ..... $.....

Red'g Inc'g } Couplings ..... to ..... in. at ..... $.....

.....Union ..... in. at ..... $.....

.....Meter ..... in. at ..... $.....

.....Lead Joints at ..... $.....

.....Compound Joints at ..... $.....

.....Hrs. Foreman at ..... $.....

.....Hrs. Chauffeur at ..... $.....

.....Hrs. Tapper at ..... $.....

.....Hrs. Labor at ..... $.....

.....Hrs. Labor at ..... $.....

.....Hrs. Compressor at ..... $.....

.....Compensation Ins. ..... $.....

.....Trucking ..... $.....

.....Builders Use of Water ..... $.....

..... $.....

..... $.....

..... $.....

..... $.....

$.....

Glen + ?

Park St. ~~Pl.~~ Ave. No. ~~10-106~~

Name of Owner

Post Star & 16+18 Park St

Building in Back, Auto Trimming Army + Kohn

Labor and Mat'l. Report Salvation #80 19

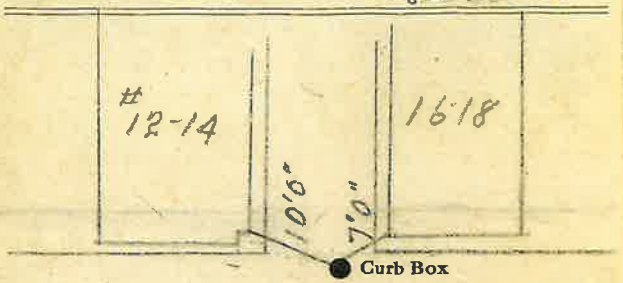

..... Main Elev. of Main at tap .....

Gate at ● ● Gate at

● Curb Box

Apr 29-48

Building in Back of 16-18 Park
Auto Trimming also 94-98-80-90

LSM-5C-6-1-45