LABOR AND MATERIALS

1	Copper ~~Lead~~ Connection	3/4	$ 1.79
1	Curb { Clock ~~Valve~~ ~~T. S. & V.~~ }	3/4 in.	$ 2.61
1	Service box Old returned { Short 3½X4½ ~~Long 4½X5½~~ ~~Buff or Rdway~~ }		$ 1.82
14	Ft. 3/4 in. { Copper ~~Galv. Iron~~ ~~Cast Iron~~ } Pipe at 23		$ 3.22
	Nipples in. at		$
	Bushings to in. at		$
	Red'g Inc'g Couplings to in. at		$
	Union in. at		$
	Meter in. at		$
	Lead Joints at		$
	Compound Joints at		$
2	Hrs. ~~Foreman~~ at WWM	84	$ 1.68
4	Hrs. Chauffeur at	75	$ 3.00
	Hrs. Tapper at		$
9	Hrs. Labor at	65	$ 5.85
	Hrs. Labor at		$
1	Hrs. Compressor at	87½	$ .88
	Compensation Ins.		$ .29
	Trucking		$ 1.00
	Builders Use of Water	?	$ 9.00
	Tap by Warsinski		$
			$
			$
			$
			$ 31.14

50-46

St. Pl. Ave. No. ~~309~~ 511

Glen St

Name of Owner

Lee H Finch

Labor and Mat'l. Report July 9 1946

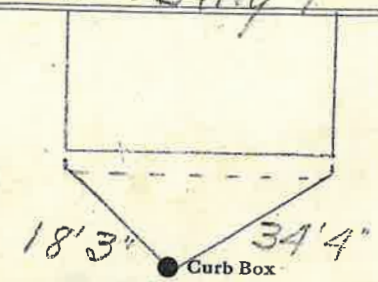

12 Main

Elev. of Main at tap 5

Gate at ●

● Gate at

TAX ID # 302.16-2-8

● Curb Box

LSM-5C-6-1-45