LABOR AND MATERIALS

Copper Lead } Connection _____ $_____

Curb { Cock / Valve / T. S. & V. } _____ in. _____ $_____

Service box Old returned { Short 3½ x 4½ / Long 4½ x 5½ / Buff or Rdway } _____ $_____

_____ Ft. 3/4 in. { Copper / ~~Gal.~~ / ~~Gal.~~ } Pipe at _____ $_____

_____ Nipples _____ in. at _____ $_____

_____ Bushings _____ to _____ in. at _____ $_____

Red'g Inc'g } Coupl'gs _____ to _____ in. at _____ $_____

_____ Union _____ in. at _____ $_____

_____ Meter _____ in. at _____ $_____

_____ Lead Joints at _____ $_____

_____ Compound Joints at _____ $_____

_____ Maintenance Foreman _____ $_____

_____ Hrs. Water Maint. Man—1 at _____ $_____

_____ Hrs. Water Maint. Man—2 at _____ $_____

_____ Hrs. Garage Foreman _____ at _____ $_____

_____ Hrs. Labor— _____ at _____ $_____

_____ Hrs. Compressor at _____ $_____

_____ Compensation Ins. at $_____ per C _____ $_____

_____ Trucking _____ $_____

_____ Pav't Patch _____ $_____

_____ $_____

_____ $_____

_____ $_____

_____ O'head _____ $_____

$_____

532 GLEN St. Pl. Ave. No. 532

Name of Owner

Labor and Mat'l. Report June 25 1979

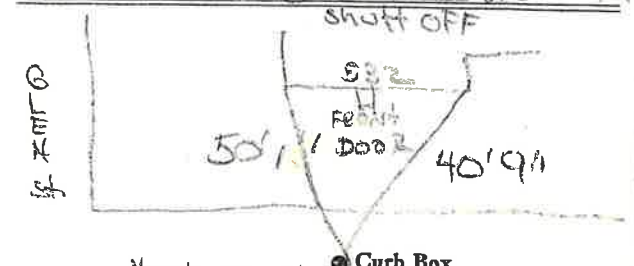

6 Main Elev. of Main at tap 5

Gate at Gate at

Curb Box

Top around the curb 1st house on left from Horicon.

LSM—5C—6-1-67