Glen St. No. 581

Name of Owner

Labor and Mat'l. Report 19 35, Sept. 4

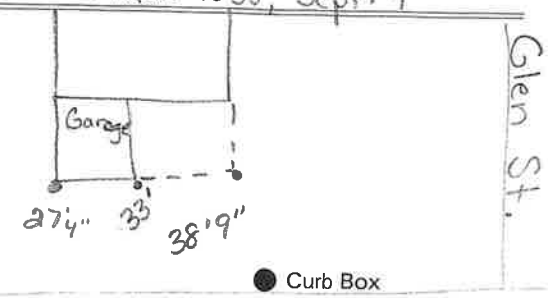

● Curb Box

ARBOR DR.

6 Main

Elev. of Main at tap 4 1/2

Gate at ●

● Gate at

● Curb Box

New House

LABOR AND MATERIALS

1 Copper ~~Lead~~ } Connection 3/4 $ ____

1 Curb } Cock ~~Valve~~ ~~T.S. & V.~~ } 3/4 in. ____ $ ____

1 Service box Old returned { Short 3-1/2 x 4-1/2 ~~Long 4-1/2 x 5-1/2~~ } ____ $ ____

9 Ft. 3/4 in. { Copper ~~Sl.~~ ~~Cl.~~ } Pipe at ____ $ ____

____ Nipples ____ in. at ____ $ ____

____ Bushings ____ to ____ in. at ____ $ ____

____ Red'g

____ Inc'g

____ Union ____ in. at ____ $ ____

____ Meter ____ in. at ____ $ ____

____ ____ $ ____

____ Compound Joints at ____ $ ____

____ Maintenance Foreman ____ $ ____

____ Hrs. Water Maint. Man - 1 at ____ $ ____

____ Hrs. Water Maint. Man - 2 at ____ $ ____

____ Hrs. Garage Foreman ____ at ____ $ ____

____ Hrs. Labor ____ at ____ $ ____

____ Hrs. Compressor at ____ $ ____

____ ____ $ ____

____ Trucking ____ $ ____

____ Pav't Patch ____ $ ____

____ ____ $ ____

____ ____ $ ____

____ ____ $ ____

____ ____ $ ____

$ ____