Glen St. ~~Ave.~~ No. 597

Name of Owner

TAX ID # 302.11-6-21

Labor and Mat'l. Report 1935, Sept. 24

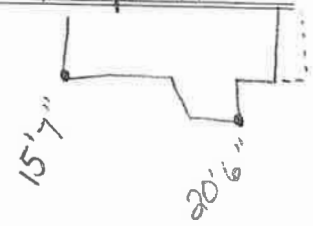

● Curb Box

12" Main

Elev. of Main at tap 4'

Gate at ●

● Gate at

● Curb Box

Old shut off at main

LABOR AND MATERIALS

1 Copper / Lead } Connection 3/4 $

1 Curb } Cock / Valve / T.S. & V. } 3/4 in. $

1 Service box Old returned { ~~Short 3-1/2 x 4-1/2~~ / Long 4-1/2 x 5-1/2 } $

11 Ft. 3/4 in. { Copper / ~~C.I.~~ / ~~C.I.~~ } Pipe at $

Nipples in. at $

Bushings to in. at $

Red'g

Inc'g

Union in. at $

Meter in. at $

$

Compound Joints at $

Maintenance Foreman $

Hrs. Water Maint. Man - 1 at $

Hrs. Water Maint. Man - 2 at $

Hrs. Garage Foreman at $

Hrs. Labor at $

Hrs. Compressor at $

$

Trucking $

Pav't Patch $

$

$

$

$

$