## LABOR AND MATERIALS

1 ... Copper / ~~Lead~~ Connection 1" ... $ 4.28

1 ... Curb Cock / ~~Valve~~ / ~~T. S. & V.~~ Cop. to Cop. Stop + Waste 1" in. ... $ 5.28

1 ... Service box Old returned Short 3½X4½ / ~~Long 4½X5½~~ / ~~Buff or Rdway~~ ... $ 4.18

8½ Ft. 1 in. Copper / ~~C. I.~~ / ~~C. I.~~ Pipe at .50 ... $ 4.25

..... Nipples ..... in. at ..... $ .....

..... Bushings ..... to ..... in. at ..... $ .....

..... Red'g / Inc'g Coupl'gs ..... to ..... in. at ..... $ .....

..... Union ..... in. at ..... $ .....

..... Meter ..... in. at ..... $ .....

..... Lead Joints at ..... $ .....

..... Compound Joints at ..... $ .....

..... Hrs. Water Maint. Man—1 at ..... $ .....

16 ... Hrs. Water Maint. Man—2 at 1.24 ... $ 19.84

18 ... Hrs. Labor— ..... at 1.13 ... $ 20.34

..... Hrs. Labor— ..... at ..... $ .....

..... Hrs. Compressor at ..... $ .....

..... Compensation Ins. at $3.86 per C ... $ 1.55

..... Trucking ..... $ 1.50

..... Pav't Patch ..... $ 11.20

Tap by Gissard 5-4-54 ..... $ .....

..... $ .....

..... $ .....

..... O'head ..... $ .....

$ 72.42

61.22

---

73-54

St. / ~~Pl.~~ / ~~Ave.~~ No. 615

Glen

**Name of Owner**

Robert Clark

**Labor and Mat'l. Report** May 4 1954

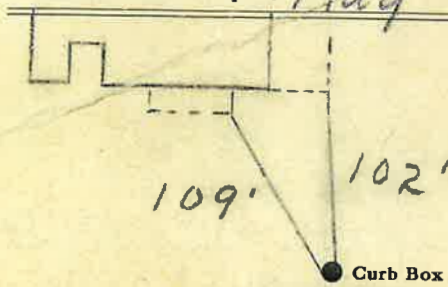


12" Main

Elev. of Main at tap 4½'

Gate at ●

● Gate at

TAX ID # 302.11-3-16

● Curb Box

Garden Connection

LSM-SC 5 15-48

## LABOR AND MATERIALS

Copper / Lead } Connection ..... $.....

Curb { Cock / Valve / T. S. & V. } ..... in. ..... $.....

Service Box Old returned { Short 3½x4½ / Long 4½x5½ / Buff or Rdway } ..... $.....

t..... in. { Copper / Galv Iron / Cast Iron } Pipe at ..... $.....

ipples ..... in. at ..... $.....

ushings ..... to ..... in. at ..... $.....

ed'g / c'g } Couplings ..... to ..... in. at ..... $.....

nion ..... in. at ..... $.....

leter ..... in. at ..... $.....

ead Joints at ..... $.....

eadite Joints at ..... $.....

rs. Foreman at ..... $.....

rs. Chauffeur at ..... $.....

rs. Tapper at ..... $.....

rs. Labor at ..... $.....

rs. Labor at ..... $.....

s. Compressor at ..... $.....

mpensation Ins. ..... $.....

ucking ..... $.....

ilders Use of Water ..... $.....

..... $.....

..... $.....

..... $.....

..... $.....

$.....

615

St.
~~Pl.~~
Ave. No. .....

Name of Owner

Labor and Mat'l. Report AUG 23 1939 19

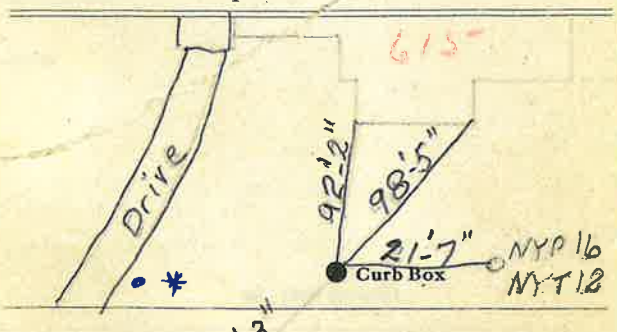


..... Main

Elev. of Main at tap.....

Gate at ●

● Gate at

Hydrant in Park

● Curb Box

another curb box found by Driveway 8/88 Unknown reason?