Labor and Materials

Copper Lead } Connection ..... $.....

Curb { Cock / Valve / T. S. & V. } ..... in ..... $.....

Service Box Old returned { Short 3½ x 4½ / Long 4½ x 5½ / Buff. or Rdway } ..... $.....

.....Ft. .....in. { Copper / Galv Iron / Cast Iron } Pipe at ..... $.....

..... Nipples ..... in. at ..... $.....

.....Bushings ..... to ..... in. at ..... $.....

Red'g Inc'g } Conplings ..... to ..... in. at ..... $.....

.....Union ..... in. at ..... $.....

.....Meter ..... in. at ..... $.....

.....Lead Joints at ..... $.....

.....Leadite Joints at ..... $.....

.....Hrs. Foreman at ..... $.....

.....Hrs. Chauffeur at ..... $.....

.....Hrs. Tapper at ..... $.....

.....Hrs. Labor at ..... $.....

.....Hrs. Labor at ..... $.....

.....Hrs. Compressor at ..... $.....

.....Compensation Ins. ..... $.....

.....Trucking ..... $.....

.....Builders Use of Water ..... $.....

..... $.....

..... $.....

..... $.....

..... $.....

$.....

Glen St. Pl. Ave. No. 394

Name of Owner

Edward R. Buck

Labor and Mat'l. Report 1/26/15 19

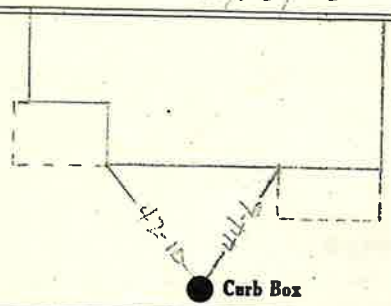

12" Main

Elev. of Main at tap ....

Gate at •

• Gate at

• Curb Box