LABOR AND MATERIALS

1	Copper ~~Lead~~ Connection	3/4	$ 1.79
1	Curb { Clock / ~~Valve~~ / ~~T. S. & V.~~ }	3/4 in.	$ 2.61
1	Service box Old returned { Short 3½X4½ / ~~Long 4½X5½~~ / Buff or Rdway }		$ 1.82
9 Ft. 3/4 in.	{ Copper / ~~Galv. Iron~~ / ~~Cast Iron~~ } Pipe at 23		$ 2.07
	Nipples ... in. at		$
	Bushings ... to ... in. at		$
	Red'g / Inc'g Couplings ... to ... in. at		$
	Union ... in. at		$
	Meter ... in. at		$
	Lead Joints at		$
	Compound Joints at		$
	Hrs. Foreman at		$
	Hrs. Chauffeur at		$
6	Hrs. Tapper at	75	$ 5.70
7	Hrs. Labor at	65	$ 4.55 10.25
	Hrs. Labor at		$
	Hrs. Compressor at		$
	Compensation Ins.		$ .28
	Trucking		$ 1.00
	Builders Use of Water.		$ 5.00
	Tapping Machine		$
			$
			$
			$
			$ 24.87

✓

43-46

St. 25
Pl.
Ave. No. 19

Grand

Name of Owner

La May

Labor and Mat'l. Report July 2 1946

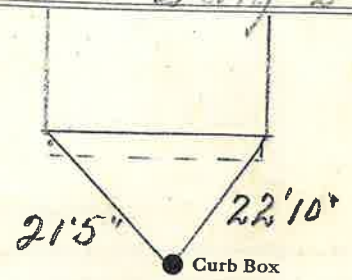

4" CI Main

Elev. of Main at tap 51'

Gate at ● ● Gate at

● Curb Box

LSM-5C-6-1-45