LABOR AND MATERIALS

1	Copper / ~~Lead~~ Connection	3/4	$ 2.29
1	Curb { Cock / ~~Valve~~ / ~~T. S. & V.~~ }	3/4 in.	$ 2.70
1	Service box { Short 3½x4½ / ~~Long 4½x5½~~ / Buff or Rdway } Old returned		$ 4.25
26	Ft. 3/4 in. { Copper / ~~G. I.~~ / ~~C. I.~~ } Pipe at 35		$ 9.10
	Nipples in. at		$
	Bushings to in. at		$
	Red'g / Inc'g Coupl'gs to in. at		$
	Union in. at		$ 1.5 10.
	Meter in. at		$
	Lead Joints at		$
	Compound Joints at		$
2	Hrs. Water Maint. Man—1 at	1.12	$ 2.24
1	Hrs. Water Maint. Man—2 at		$ 1.02
8	Hrs. Labor— at	91	$ 7.28
	Hrs. Labor— at		$
	Hrs. Compressor at		$
	Compensation Ins. at $ per C.		$ .23
	Trucking		$ 1.—
	Pav't Patch	B.P.	$
			$
			$
			$
	O'head		$
			$ 30.11

Before Paving

St. / ~~Pl.~~ Grand Ave. No. 26

Name of Owner

Julia Holleran

Labor and Mat'l. Report July 5 1950

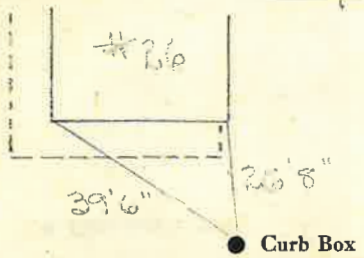

4 Main

Elev. of Main at tap 5

Gate at ● ● Gate at

● Curb Box

39' 6"

26' 8"

LSM-5C 10-21-49