LABOR AND MATERIALS

1	Copper Lead — Connection	3/4	$ 2.29
1	Curb — Cock / ~~Valve~~ / ~~T. S. & V.~~	3/4 in.	$ 2.70
1	Service box — Old returned — Short 3½x4½ / ~~Long 4½x5½~~ / ~~Buff or Rdway~~		$ 4.25
8	Ft. 3/4 in. — Copper / ~~G. I.~~ / ~~C. I.~~ Pipe at 35		$ 2.80
	Nipples ____ in. at		$
	Bushings ____ to ____ in. at		$
	Red'g / Inc'g Coupl'gs ____ to ____ in. at		$
	Union ____ in. at		$
	Meter ____ in. at		$
	Lead Joints at		$ 19.91
	Compound Joints at		$
2	Hrs. Water Maint. Man—1 at		$ 3.24
4	Hrs. Water Maint. Man—2 at		$ 4.08
	Hrs. Labor— at		$
15	Hrs. Labor— at 91		$ 13.65
	Hrs. Compressor at		$
	Compensation Ins. at $ ____ per C.		$ .44
	Trucking		$ 1.—
	Pav't Patch B.P.		$
			$
			$
			$
	O'head		$
			$ 33.45

~~11-7-49~~ Before Paving

✓

St. / ~~Pl.~~ Ave. No. 39

Grand

Name of Owner

Ronald Hau

Labor and Mat'l. Report July 6 19 50

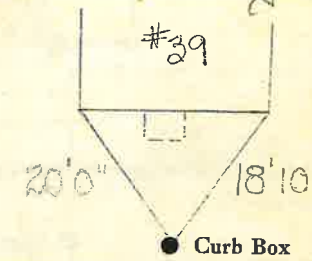

4" Main — Elev. of Main at tap 4½

Gate at ● — ● Gate at

● Curb Box

LSM-5C 10-21-49