LABOR AND MATERIALS

1	Copper / ~~Lead~~ Connection 3/4"	$ 3.20
1	Curb Cock / ~~Valve~~ / ~~T. S. & V.~~ in.	$ 1.00
1	Service box ~~Old returned~~ Short 3½x4½ / ~~Long 4½x5½~~ / ~~Buff or Rdway~~	$ 1.30
25	Ft. 3/4 in. Copper / ~~G. I.~~ / ~~C. I.~~ Pipe at	$ 5.50
	Nipples in. at	$
	Bushings to in. at	$
1	Red'g / Inc'g Coupl'gs Brass to in. at	$ .15
	Union in. at	$
	Meter in. at	$
	Lead Joints at	$
	Compound Joints at	$
	Hrs. Water Maint. Man—1 at	$
2	Hrs. Water Maint. Man—2 at 52.5	$ 1.25
7	Hrs. Labor— at 50	$ 3.50
7	Hrs. Labor— at 40 5/8	$ 2.85
	Hrs. Compressor at	$
	Compensation Ins. at $ per C.	$ .21
	Trucking	$ 1.00
	Pav't Patch	$
		$
		$
		$
	O'head	$
		$ 19.96

26 - #68

Grant ~~St.~~ ~~Pl.~~ Ave. No. 65

Name of Owner

Measure in card 8-17-51

Labor and Mat'l. Report July 2 1926

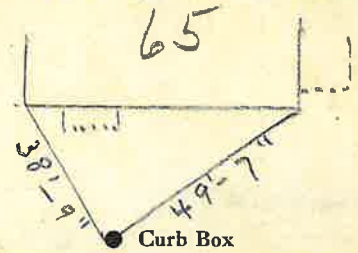

Main

Elev. of Main at tap

Gate at ●

● Gate at

● Curb Box

LSM-5C 10-21-49