LABOR AND MATERIALS

1 ~~Copper~~ Lead } Connection ---------- $----------

1 Curb { Cock / ~~Valve~~ / ~~T. S. & V.~~ } ---------- in. ---------- $----------

1 Service Box ~~Old returned~~ { Short 3½x4½ / ~~Long 4½x5½~~ / ~~Buff. on Rdway~~ } ---------- $----------

26 Ft. 3/4 in. { ~~Copper~~ / Galv Iron / ~~Cast Iron~~ } Pipe at ---- $----------

---------- Nipples ---------- in. at ---------- $----------

---------- Bushings ---------- to ---------- in. at ---------- $----------

---------- Red'g / Inc'g } Couplings ---- to ---- in. at ---------- $----------

---------- Union ---------- in. at ---------- $----------

---------- Meter ---------- in. at ---------- $----------

---------- Lead Joints at ---------- $----------

---------- Leadite Joints at ---------- $----------

---------- Hrs. Foreman at ---------- $----------

---------- Hrs. Chauffeur at ---------- $----------

---------- Hrs. Tapper at ---------- $----------

---------- Hrs. Labor at ---------- $----------

---------- Hrs. Labor at ---------- $----------

---------- Hrs. Compressor at ---------- $----------

---------- Compensation Ins. ---------- $----------

---------- Trucking ---------- $----------

---------- Builders Use of Water ---------- $----------

---------- $----------

---------- $----------

---------- $----------

---------- $----------

$----------

2

Grant Ave. No. 71

Name of Owner

Labor and Mat'l. Report Aug. 28 19 29

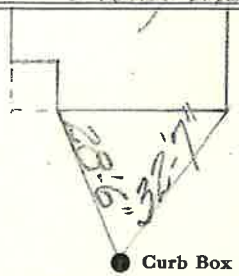

● Curb Box

6" Main

Elev. of Main at tap 5'1

Gate at ● ● Gate at

● Curb Box