LABOR AND MATERIALS

1	Copper ~~Lead~~ Connection	1"	$ 2.47
1	Curb { Cock ~~Valve~~ ~~T. S. & V.~~ }	1" in.	$ 3.16
1	Service Box Old returned { Short 3½x4½ ~~Long 4½x5½~~ Buff or Rdway }		$ 1.70
24	Ft. 1" in. { Copper ~~Galv Iron~~ ~~Cast Iron~~ }	Pipe at 24	$ 5.76
	Nipples ..... in. at		$
	Bushings ..... to ..... in. at		$
	Red'g Inc'g } Couplings ..... to ..... in. at		$
	Union ..... in. at		$
	Meter ..... in. at		$
	Lead Joints at		$
	Leadite Joints at		$
5	Hrs. Foreman at	.62½	$ 3.13
8	Hrs. Tapper at	"	$ 5.—
9	Hrs. Labor at	.45	$ 4.05
	Hrs. Labor at		$
1	Hrs. Compressor at	.62½	$ .62
	Compensation Ins.		$ .37
	Trucking		$ 1.—
	Builders Use of Water	Patch.	$ 9.—
Tag 4 Hrs.			$
			$
			$
			$
			$ 36.26

B 5 1941

412-414

St.
~~Pl.~~
Ave. No. 24

Calvert

Name of Owner

Spellman

Labor and Mat'l. Report May 7 1941

412-414

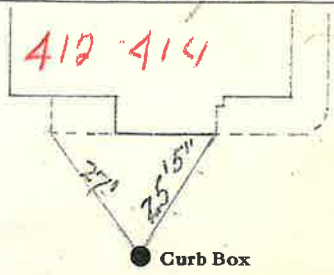

6 Main Notre Dame St. Elev. of Main at tap 5—

Gate at ● ● Gate at

● Curb Box