## LABOR AND MATERIALS

| | | | |
|---|---|---|---|
| 1 | Copper ~~Lead~~ Connection | 3/4 | $ 1.23 |
| 1 | Curb { Cock ~~Valve~~ ~~I. S. & V.~~ } | 3/4 in. | $ 1.68 |
| 1 | Service Box Old returned { Short 3½x4½ ~~Long 4½x8½~~ ~~Buff. or Rdway~~ } | | $ 1.75 |
| 35 | Ft. 3/4 in. { Copper ~~Galv Iron~~ ~~Cast Iron~~ } | Pipe at 15 | $ 5.25 |
| | Nipples ____ in. at | | $ |
| | Bushings ____ to ____ in. at | | $ |
| | Red'g Inc'g Couplings ____ to ____ in. at | | $ |
| | Union ____ in. at | | $ |
| | Meter ____ in. at | | $ |
| | Lead Joints at | | $ |
| | Leadite Joints at | | $ |
| | Hrs. Foreman at | | $ |
| 1 | Hrs. Chauffeur at 62½ | | $ 2.50 |
| 2 | Hrs. Tapper at ~~-~~ | | $ 1.25 |
| 16 | Hrs. Labor at 45 | | $ 7.20 |
| | Hrs. Labor at | | $ |
| 2 | Hrs. Compressor at 87½ | | $ 1.75 |
| | Compensation Ins. | | $ 34 |
| | Trucking | | $ 1.00 |
| | Builders Use of Water Patch | | $ 9.00 |
| | Tap by Town | | $ |
| | | | $ |
| | | | $ |
| | | | $ |
| | | | $ 32.95 |

1 3 3 - 1938

St. 434
~~Pl.~~
Glen Ave. No. 258

**Name of Owner**

Hooper

**Labor and Mat'l. Report** Sept 22 19 32

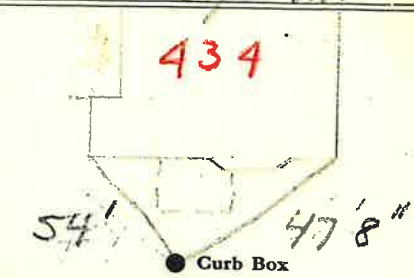


12 Main — Elev. of Main at tap 4½

Gate at ● ● Gate at

● Curb Box

old shut off