LABOR AND MATERIALS

1	Copper ~~Lead~~ } Connection 1"	$2.79
1	Curb { Cock ~~Valve~~ ~~T. S. & V.~~ } 1" in.	$3.60
1	Service Box Old returned { Short 3½x4½ ~~Long 4½x5½~~ Buff or Rdway }	$1.82
35	Ft. 1" in. { Copper ~~Galv Iron~~ ~~Cast Iron~~ } Pipe at 22	$7.70
	Nipples ... in. at	$
	Bushings ... to ... in. at	$
	Red'g Inc'g } Couplings ... to ... in. at	$
	Union ... in. at	$
	Meter ... in. at	$
	Lead Joints at	$
	Leadite Joints at	$
	Hrs. Foreman at	$
28	Hrs. Chauffeur at 6.83¼	$ 19.25
	Hrs. Tapper at	$
8	Hrs. Labor at .60	$ 4.80
	Hrs. Labor at	$
4	Hrs. Compressor at .8½	$ 3.50
	Compensation Ins.	$ .64
	Trucking 2.669	$ 1.—
	Builders Use of Water	$ 17.10
	Tapping Millers at Warsinski	$
		$
		$
		$
		$ 67.20

St. 56-62
Pl.
Ave. No. 40-42

Glen

Name of Owner

Miro Cleaner

Labor and Mat'l. Report Oct 23 19 49

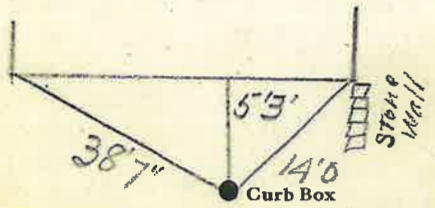

10 Main

Elev. of Main at tap 5

Gate at ● ● Gate at

35' 1" to MAIN

1" Copper ● Curb Box

#56 TAX ID # 310.5-1-4