LABOR AND MATERIALS

1	Copper ~~Lead~~ Connection 1"	$ 2.47
1	Curb {Cock ~~Valve~~ ~~T. S. & V.~~} 1" in.	$ 3.16
1	Service Box Old returned {~~Short 3⅛x4⅛~~ Long 4⅛x5⅛ ~~Buff or Rdway~~}	$ 1.70
32	Ft. 1" in. {Copper Galv Iron Cast Iron} Pipe at 24	$ 7.68
	Nipples in. at	$
	Bushings to in. at	$
	Red'g Inc'g Couplings to in. at	$
	Union in. at	$
	Meter in. at	$
	Lead Joints at	$
	Leadite Joints at	$
	Hrs. Foreman at	$
9	Hrs. Chauffeur at .62½	$ 5.63
15	Hrs. Tapper at	$ 9.37
15	Hrs. Labor at .45	$ 6.75
	Hrs. Labor at	$
4	Hrs. Compressor at .62½	$ 2.50
	Compensation Ins.	$ .66
	Trucking	$ 1.—
	Builders Use of Water Patch	$ 9.—
	Tap by Hessel	$
		$
		$
		$
		$ 49.92

9 1 1941

St. ~~Pl.~~ 454
Glen Ave. No. 278

Name of Owner

Buddy

Labor and Mat'l. Report June 30 19 41

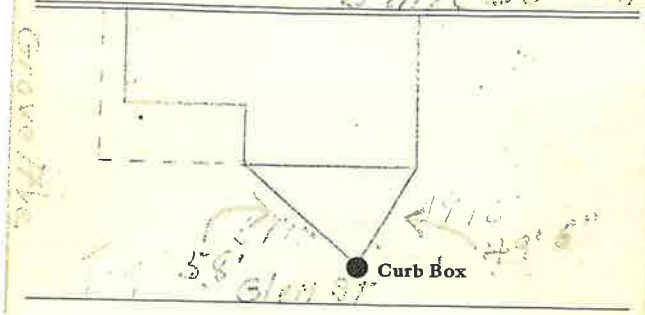

12 Main

Elev. of Main at tap 4½

Gate at ● ● Gate at

● Curb Box

To be Billed