LABOR AND MATERIALS

1 Copper ~~Iron~~ } Connection 3/4" $

1 Curb { Cock / ~~Valve~~ / ~~T.H.&V.~~ } 3/4 in. (MARK II ORISEAL) $

1 Service box { Short 3½ x 4½ / ~~Long 4½ x 5½~~ / ~~Buff or Rdway~~ } Old returned ____ $

7 Ft. 3/4 in. { Copper / ~~Galv.~~ / ~~Cast~~ } Pipe at ____ $

____ Nipples ____ in. at ____ $

____ Bushings ____ to ____ in. at ____ $

____ Red'g Inc'g } Coupl'gs ____ to ____ in. at ____ $

____ Union ____ in. at ____ $

____ Meter ____ in. at ____ $

____ Lead Joints at ____ $

____ Compound Joints at ____ $

____ Maintenance Foreman ____ $

____ Hrs. Water Maint. Man—1 at ____ $

____ Hrs. Water Maint. Man—2 at ____ $

____ Hrs. Garage Foreman ____ at ____ $

____ Hrs. Labor— ____ at ____ $

____ Hrs. Compressor at ____ $

____ Compensation Ins. at $ ____ per C ____ $

____ Trucking ____ $

____ Pav't Patch ____ $

____ $

TAP Made By Pock ____ $

____ $

____ O'head 9-6-1972 ____ $

____ $

#6 & 8

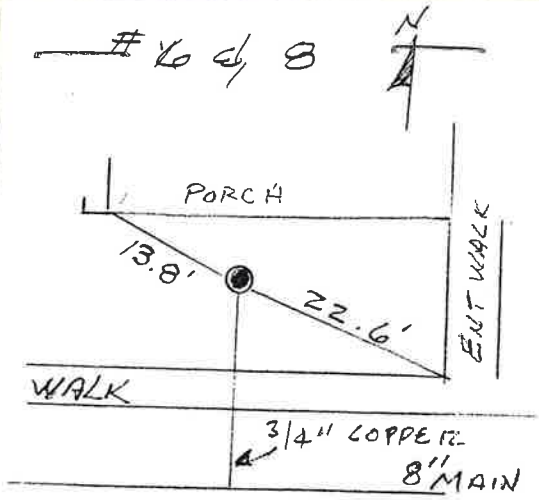

7'± to MAIN

ELEV to TAP 5.5'±

SEPT. 2006

LSM—5C—6-1-67