LABOR AND MATERIALS

1 Copper / ~~Lead~~ Connection 3/4 $ _____

1 Curb { Cock / ~~Valve~~ / ~~T.S. & V.~~ } 3/4 in. _____ $ _____

1 Service box { Short 3-1/2 x 4-1/2 / ~~Long 4-1/2 x 5-1/2~~ } Old returned _____ $ _____

8 Ft. 3/4 in. { Copper / ~~G.I.~~ / ~~G.I.~~ } Pipe at _____ $ _____

_____ Nipples _____ in. at _____ $ _____

_____ Bushings _____ to _____ in. at _____ $ _____

_____ Red'g

_____ Inc'g

_____ Union _____ in. at _____ $ _____

_____ Meter _____ in. at _____ $ _____

_____ _____ $ _____

_____ Compound Joints at _____ $ _____

_____ Maintenance Foreman _____ $ _____

_____ Hrs. Water Maint. Man - 1 at _____ $ _____

_____ Hrs. Water Maint. Man - 2 at _____ $ _____

_____ Hrs. Garage Foreman _____ at _____ $ _____

_____ Hrs. Labor _____ at _____ $ _____

_____ Hrs. Compressor at _____ $ _____

_____ _____ $ _____

_____ Trucking _____ $ _____

_____ Pav't Patch _____ $ _____

_____ _____ $ _____

_____ _____ $ _____

_____ _____ $ _____

_____ _____ $ _____
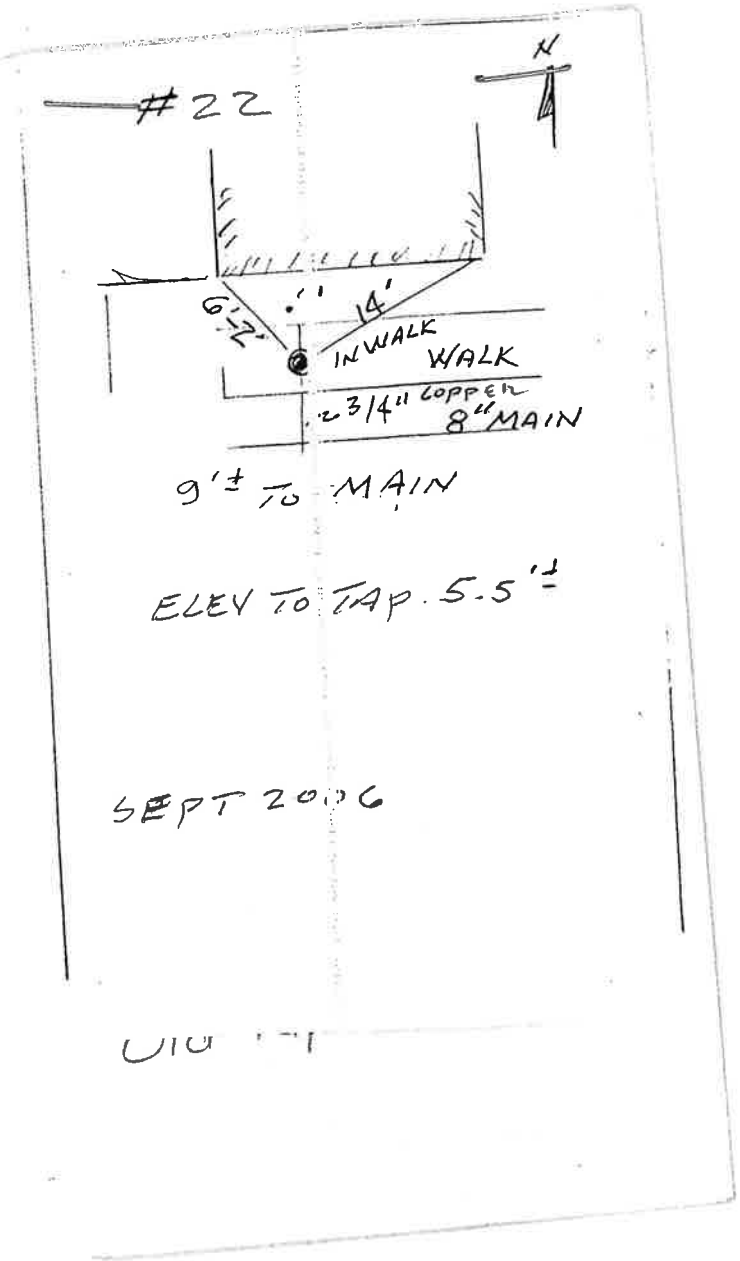
$ _____