LABOR AND MATERIALS

1	Copper / ~~Lead~~ Connection 3/4"	$ 2.29	
1	Curb Cock / Valve / T. S. & V. 3/4 in.	$ 2.70	
1	Service box Old returned Short 3½x4½ / Long 4½x5½ / Buff or Rdway	$ 4.25	
26	Ft. 3/4 in. Copper / ~~C. I.~~ / ~~C. I.~~ Pipe at 35	$ 9.10	
	Nipples in. at	$	
	Bushings to in. at	$	
	Red'g / Inc'g Coupl'gs to in. at	$	
	Union in. at	$	
	Meter in. at	$	
	Lead Joints at	$ 18	
	Compound Joints at	$	
7	Hrs. Water Maint. Man—1 at	$ 7.24	
1	Hrs. Water Maint. Man—2 at	$ 1.02	
	Hrs. Labor— at	$	
5	Hrs. Labor— at 91	$ 4.55	
	Hrs. Compressor at	$	
	Compensation Ins. at $ per C.	$ .17	
	Trucking	$ 1.17	
	Pav't Patch B. P.	$	
		$	
		$	
		$	
	O'head	$	
		$ 27.32	

1122-1950 ✓ Before Paving

St. / ~~Pl.~~ / ~~Ave.~~ No. 24

Grand

Name of Owner

Garland Treores.

Labor and Mat'l. Report July 5 1950

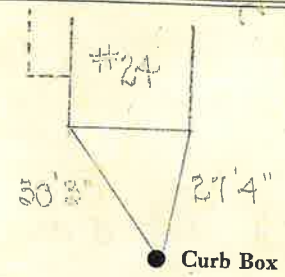

4 Main

Elev. of Main at tap 5

Gate at ●

● Gate at

● Curb Box

LSM-5C 10-21-49