LABOR AND MATERIALS

1 Copper / ~~Lead~~ } Connection 3/4 $ 2.94

1 Curb { Clock / ~~Valve~~ / ~~T. S. & V.~~ } 3/4 in. $ 3.71

1 Service box Old returned { Short 3½X4½ / ~~Long 4½X5½~~ / Buff or Rdway } $ 5.90

27 Ft. 3/4 in. { Copper / ~~Galv. Iron~~ / ~~Cast Iron~~ } Pipe at 30 $ 8.10

Nipples in. at $

Bushings to in. at $

Red'g / Inc'g } Couplings to in. at $

Union in. at $

Meter in. at $

Lead Joints at $

Compound Joints at $

2 Hrs. ~~Foreman at~~ WMM-1 101 $ 202

7½ Hrs. ~~Chauffeur at~~ WMM-2 91 $ 683.25

Hrs. Tapper at $

10 Hrs. Labor at 80 $ 800

Hrs. Labor at $

~~8~~ 1 Hrs. Compressor at 1.20 $ 3.60

Compensation Ins. $ 37

Trucking $ 1.00

Builders Use of Water $ 13.40

Tap by Magnan $

$

$

$

$ 5587

14

St. / ~~Pl.~~ / ~~Ave.~~ No. 30

Grant

Name of Owner

Orgen

Labor and Mat'l. Report April 15 1948

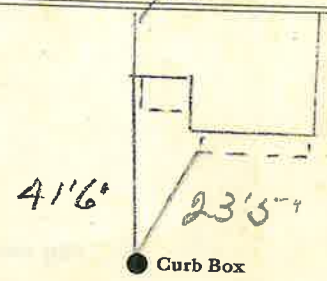

4" Cal Main

Elev. of Main at tap 4½

Gate at

Gate at

Curb Box

LSM-5C-6-1-45