LABOR AND MATERIALS

1	Copper / ~~Lead~~ Connection 3/4		$ 2.94
1	Curb { Clock / ~~Valve~~ / T. S. & V. } 3/4 in.		$ 3.71
1	Service box / Old returned { Short 3½X4½ / ~~Long 4½X5½~~ / Buff or Rdway }		$ 5.90
28	Ft. 3/4 in. { Copper / ~~Galv. Iron~~ / Cast Iron } Pipe at 30		$ 8.40
	Nipples in. at		$
	Bushings to in. at		$
	Red'g / Inc'g } Couplings to in. at		$
	Union in. at		$
	Meter in. at		$
	Lead Joints at		$
	Compound Joints at		$
4	Hrs. ~~Foreman at~~ WMM-1	1.01	$ 4.04
5½	Hrs. ~~Chauffeur at~~ WMM-2	91	$ 5.00
	Hrs. Tapper at		$
14	Hrs. Labor at	90	$ 11.20
	Hrs. Labor at		$
3	Hrs. Compressor at	1.20	$ 3.60
	Compensation Ins.		$ .45
	Trucking		$ 1.00
	Builders Use of Water		$ 18.70
	tap by Watsin sl.		$
			$
			$
			$
			$ 64.94

15

Grand St. ~~Pl.~~ ~~Ave.~~ No. 34

Name of Owner

Manfield

Labor and Mat'l. Report Apr 15 1948

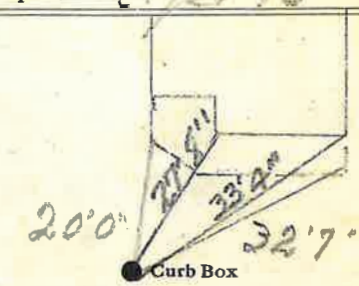

4" Gal Main

Elev. of Main at tap 4½

Gate at ● ● Gate at

TAX ID # 302.16-17-48

● Curb Box

LSM-5C-6-1-45