LABOR AND MATERIALS

1	Copper / ~~Lead~~ Connection 3/4"		$ 2.29
1	Curb Cock / ~~Valve~~ / ~~T. S. & V.~~ 3/4 in.		$ 2.70
1	Service box Old returned Short 3½x4½ / ~~Long 4½x5½~~ / ~~Buff or Rdway~~		$ 4.25
8	Ft. 3/4 in. Copper / ~~G. I.~~ / ~~C. I.~~ Pipe at 35		$ 2.80
	Nipples in. at		$
	Bushings to in. at		$
	Red'g / Inc'g Coupl'gs to in. at		$
	Union in. at		$
	Meter in. at		$
	Lead Joints at		$
	Compound Joints at		$
2	Hrs. Water Maint. Man—1 at 1.12		$ 3.24
5	Hrs. Water Maint. Man—2 at 1.02		$ 5.10
9	Hrs. Labor— at 91		$ 8.19
	Hrs. Labor— at		$
1	Hrs. Compressor at		$ 1.20
	Compensation Ins. at $ per C.		$ .35
	Trucking		$ 1.00
	Pav't Patch B.P.		$
			$
			$
			$
	O'head		$
			$ 30.12

76-1950 Before Paving

✓

St. / ~~Pl.~~ / Ave. No. 35

Grand

Name of Owner

Russell Robinson

Labor and Mat'l. Report July 6 1950

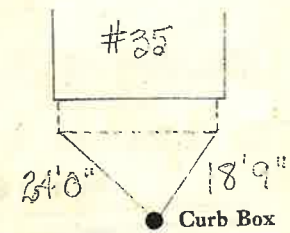

4 Main

Elev. of Main at tap 4½

Gate at ●

● Gate at

● Curb Box

LSM-5C 10-21-49