LABOR AND MATERIALS

1	Copper Lead — Connection	3/4	$ 2.29
1	Curb — Cock / Valve / T. S. & V.	3/4 in.	$ 2.70
1	Service box — Old returned — Short 3½x4½ / Long 4½x5½ / Buff or Rdway		$ 4.25
8	Ft. 3/4 in. — Copper / G. I. / C. I. — Pipe at 35		$ 2.80
	Nipples in. at		$
	Bushings to in. at		$
	Red'g / Inc'g — Coupl'gs to in. at		$
	Union in. at		$
	Meter in. at		$ ✓
	Lead Joints at		$ 9.85
	Compound Joints at		$
2	Hrs. Water Maint. Man—1 at		$ 2.24
3	Hrs. Water Maint. Man—2 at		$ 3.06
5	Hrs. Labor— at	91	$ 4.55
	Hrs. Labor— at		$
	Hrs. Compressor at		$
	Compensation Ins. at $ per C.		$ .22
	Trucking		$ 1.—
	Pav't Patch — B.P.		$
			$
			$
			$
	O'head		$
			$ 23.11

Before Paving

✓

St. Pl. Ave. No. Grand 43

Name of Owner

Dr. Seymour Hopfan

Labor and Mat'l. Report July 6 1950

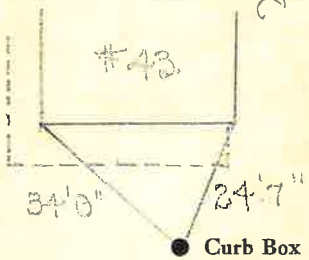

● Curb Box

4" Main

Elev. of Main at tap -1'

Gate at ●

● Gate at

● Curb Box

LSM-5C 10-21-49