LABOR AND MATERIALS

1	Copper / ~~Lead~~ — Connection	3/4"	$ 2.29
1	Curb — Cock / ~~Valve~~ / ~~T. S. & V.~~	3/4" in.	$ 2.70
1	Service box — Old returned — Short 3½x4½ / ~~Long 4½x5½~~ / Buff or Rdway		$ 4.25
26 Ft.	3/4 in. — Copper / ~~G. I.~~ / ~~C. I.~~ — Pipe at 35		$ 9.10
	Nipples in. at		$
	Bushings to in. at		$
	Red'g / Inc'g — Coupl'gs to in. at		$
	Union in. at		$
	Meter in. at		$ 12.50
	Lead Joints at		$
	Compound Joints at		$
4	Hrs. Water Maint. Man—1 at	1.02	$ 4.08
1	Hrs. Water Maint. Man—2 at	1.07	$ 11.83
13	Hrs. Labor— at	91	$
	Hrs. Labor— at		$
1	Hrs. Compressor at		$ 1.20
	Compensation Ins. at $ per C.		$ 35
	Trucking		$ 1
	Pav't Patch B.P.		$
			$
			$
			$
	O'head		$
			$ 36.80

Before Paving

115-1450

St. / ~~Pl.~~ Grand Ave. No. 8

Name of Owner

Lloyd E. Gravalle

Labor and Mat'l. Report July 5 1950

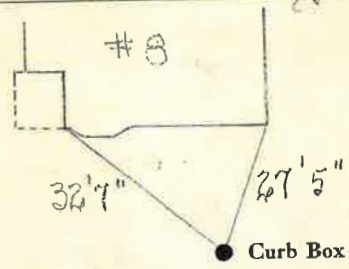

4" Main

Elev. of Main at tap 5'

Gate at ● ● Gate at

TAX ID # 302.16-17-35

● Curb Box

LSM-5C 10-21-49