LABOR AND MATERIALS

1	Copper ~~Lead~~ Connection	3/4"	$ 2.71
1	Curb ~~Cock Valve T. S. & V.~~	3/4 in.	$ 3.83
1	Service box Old returned ~~Short 3½ x 4½ Long 4½ x 5½ Buff or Rdway~~		$ 4.69
11	Ft. 3/4 in. ~~Copper G. I. C. I.~~ Pipe at 45		$ 4.95
	Nipples in. at		$
	Bushings to in. at		$
	Red'g Inc'g Coupl'gs to in. at		$
	Union in. at		$
	Meter in. at		$
	Lead Joints at		$
	Compound Joints at		$ 25.30
	Maintenance Foreman		$
4	Hrs. Water Maint. Man—1 at	1.24	$ 4.96
	Hrs. Garage Foreman at		$
18	Hrs. Labor— at	1.13	$ 20.34
	Hrs. Compressor at		$
	Compensation Ins. at $ 4.29 per C		$ 1.09
	Trucking		$ 1.56
	Pav't Patch		$ 7.20
Tap by Gifford 5-6-55			$
			$
			$
	O'head		$
			$ 51.27

~~St.~~ ~~Pl.~~ Grant Ave. No. 64

Name of Owner

J. E. McNairy

Labor and Mat'l. Report May 6 1955

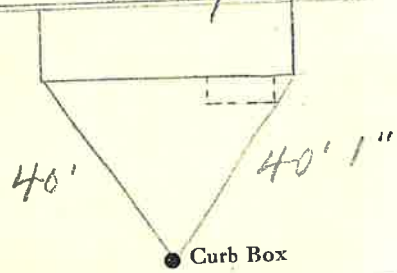

6" Main

Elev. of Main at tap 4½'

Gate at •

• Gate at

• Curb Box

L M—5C—2-1-54