LABOR AND MATERIALS

Copper Lead	Connection	$
Curb	Cock / Valve / T. S. & V. ____ in.	$
Service box Old returned	Short 3½ x 4½ / Long 4½ x 5½	$
Ft. 3/4 in.	Copper / ~~G. I.~~ / ~~C. I.~~ Pipe at	$
Nipples	in. at	$
Bushings	to in. at	$
Red'g. Inc'g	Coupl'gs to in. at	$
Union	in. at	$
Meter	in. at	$
		$
Compound Joints at		$
Maintenance Foreman		$
Hrs. Water Maint. Man—1 at		$
Hrs. Water Maint. Man—2 at		$
Hrs. Garage Foreman	at	$
Hrs. Labor—	at	$
Hrs. Compressor at		$
		$
Trucking		$
Pav't Patch		$
		$
		$
		$
		$
		$

Grant ~~St.~~ ~~Pl.~~ Ave. No. 68

Name of Owner

Grosd

Labor and Mat'l. Report 19 88

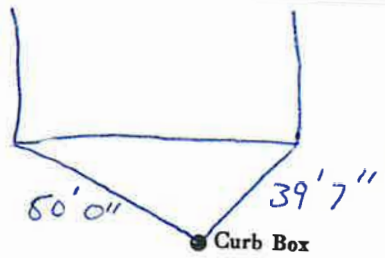

Main Elev. of Main at tap

Gate at ● ● Gate at

TAX ID # 302.19-15-15

● Curb Box

LSM—5C—6-1-67