LABOR AND MATERIALS

1	Copper / ~~Lead~~ Connection	3/4"	$ 2.71
1	Curb — Cock / ~~Valve~~ / T. S. & V.	3/4 in. Medium box	$ 3.83
1	Service box — Old returned — ~~Short 3½ x 4½~~ / Long 4½ x 5½ / ~~Buff or Redway~~	4' x 5"	$ 4.69
25'	Ft. 3/4 in. — Copper / ~~C.I.~~ / ~~G.I.~~ Pipe at	45	$ 11.25
	Nipples in. at		$
	Bushings to in. at		$
	Red'g / Inc'g Coupl'gs to in. at		$
	Union in. at		$
	Meter in. at		$
	Lead Joints at		$ 10.40
6	Compound Joints at		$ 6.00
6	Maintenance Foreman	1.51	$ 9.06
	Hrs. Water Maint. Man—1 at		$
6	Hrs. Water Maint. Man—2 at	1.24	$ 7.44
	Hrs. Garage Foreman at		$
30	Hrs. Labor— at	1.13	$ 33.90
	Hrs. Compressor at		$
	Compensation Ins. at $ 4.29 per C		$ 2.16
	Trucking		$ 1.50
	Pav't Patch		$ 11.25
Tap by Gisgord 12-9-54			$
			$
			$
	O'head		$
			$ 87.79

~~St.~~ Pl. Ave. No. 22

Grove

Name of Owner

Cohn.

Labor and Mat'l. Report Dec. 9 1954

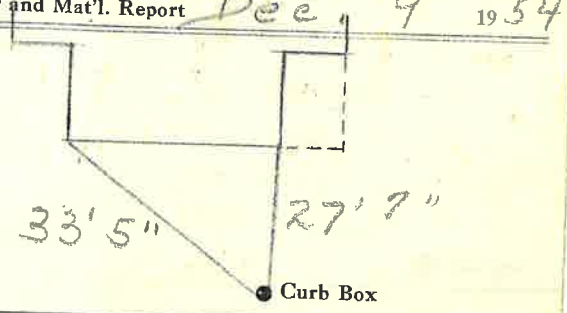

6" Main

Elev. of Main at tap 5'

Gate at

Gate at

Curb Box

L-M—5C—2-1-54