LABOR AND MATERIALS

Copper / Lead } Connection ..... $.....

Curb { Cock / Valve / T. S. & V. } ..... in. ..... $.....

Service Box / Old returned { Short 3½x4½ / Long 4½x5½ / Buff or Rdway } ..... $.....

11 Ft. 3/4 in. { Copper / Galv Iron / Cast Iron } Pipe at ..... $.....

Nipples ..... in. at ..... $.....

Bushings ..... to ..... in. at ..... $.....

Red'g / Inc'g } Couplings ..... to ..... in. at ..... $.....

Union ..... in. at ..... $.....

Meter ..... in. at ..... $.....

Lead Joints at ..... $.....

Leadite Joints at ..... $.....

Hrs. Foreman at ..... $.....

Hrs. Chauffeur at ..... $.....

Hrs. Tapper at ..... $.....

Hrs. Labor at ..... $.....

Hrs. Labor at ..... $.....

Hrs. Compressor at ..... $.....

Compensation Ins. ..... $.....

Trucking ..... $.....

Builders Use of Water ..... $.....

..... $.....

..... $.....

..... $.....

..... $.....

$.....

Grove ~~St.~~ ~~Pl.~~ Ave. No. 35

Name of Owner

Labor and Mat'l. Report AUG 2 4 1939 19

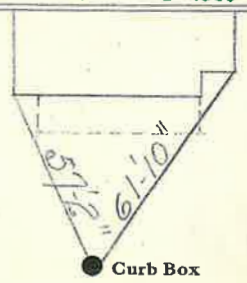

TAX ID # 302.19-20-15

Main ..... Elev. of Main at tap .....

Gate at ● ● Gate at

● Curb Box