## LABOR AND MATERIALS

1 Copper ~~Lead~~ Connection 3/4" $

1 Curb Cock ~~Valve~~ T. S. & V. 3/4 in. $

1 Service box Old returned Short 3½ x 4½ ~~Long 4½ x 5½~~ ~~Buff or Rdway~~ $

20 Ft. 3/4 in. Copper ~~G. I.~~ ~~C. I.~~ Pipe at $

Nipples in. at $

Bushings to in. at $

Red'g Inc'g Coupl'gs to in. at $

Union in. at $

Meter in. at $

Lead Joints at $

Compound Joints at $

Maintenance Foreman $

Hrs. Water Maint. Man—1 at $

Hrs. Water Maint. Man—2 at $

Hrs. Garage Foreman at $

Hrs. Labor— at $

Hrs. Compressor at $

Compensation Ins. at $ per C $

Trucking $

Pav't Patch $

Tap by Gifford & Co. 12-17-59. $

$

O'head $

$

V

~~St.~~ ~~Pl.~~ Grove Ave. No. 40

Name of Owner

Perry

Labor and Mat'l. Report Dec. 17 1959

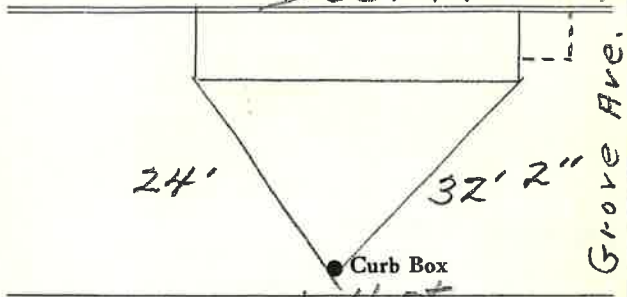


Crandall St.

10" Main Elev. of Main at tap 6'

Gate at • • Gate at

TAX ID # 302.19-22-6

• Curb Box

LSM—5C—2-5 56