LABOR AND MATERIALS

1	Copper / ~~Lead~~ Connection	3/4	$ 1.31
1	Curb { Cock / ~~Valve~~ / ~~T. S. & V.~~ }	3/4 in.	$ 1.75
	Service Box Old returned { ~~Short 3½x4½~~ / ~~Long 4½x5½~~ / ~~Buff. or Rdway~~ }	Used Same	$ —
18	Ft. 3/4 in. { Copper / ~~Galv Iron~~ / ~~Cast Iron~~ }	Pipe at 18	$ 8.10
	Nipples	in. at	$
	Bushings	to in. at	$
	Red'g / Inc'g Couplings	to in. at	$
	Union	in. at	$
	Meter	in. at	$
	Lead Joints at		$
	Leadite Joints at		$
	Hrs. Foreman at		$
5	Hrs. Chauffeur at	62½	$ 3.13
12	Hrs. Tapper at		$ 7.50
14	Hrs. Labor at	45	$ 6.30
	Hrs. Labor at		$
1	Hrs. Compressor at	62½	$ .63
	Compensation Ins.		$ 52
	Trucking		$ 1.—
	Builders Use of Water	2 Patches	$ 18.—
Tap by Hessel			$
			$
			$
			$
			$ 48.24

FEB -- 1940

St.--
Pl.--
Grove Ave Ave. No. 54

Name of Owner

Dixon Est

Labor and Mat'l. Report Apr 30 1940

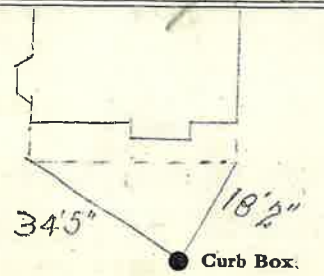

6 Main — Elev. of Main at tap 5"

Gate at ● — ● Gate at

● Curb Box

To be billed