LABOR AND MATERIALS

1 Copper / ~~Lead~~ } Connection _____ $ _____

1 Curb { Cock / ~~Valve~~ / ~~T.S.&V.~~ } _____ in. _____ $ _____

1 Service box { ~~Short 3-1/2 x 4-1/2~~ / Long 4-1/2 x 5-1/2 } _____ $ _____
Old returned

8 Ft. 3/4 in. { Copper / ~~Gal.~~ / ~~Gal.~~ } Pipe at _____ $ _____

_____ Nipples _____ in. at _____ $ _____

_____ Bushings _____ to _____ in. at _____ $ _____

_____ Red'g

_____ Inc'g

_____ Union _____ in. at _____ $ _____

_____ Meter _____ in. at _____ $ _____

_____ _____ $ _____

_____ Compound Joints at _____ $ _____

_____ Maintenance Foreman _____ $ _____

_____ Hrs. Water Maint. Man - 1 at _____ $ _____

_____ Hrs. Water Maint. Man - 2 at _____ $ _____

_____ Hrs. Garage Foreman _____ at _____ $ _____

_____ Hrs. Labor _____ at _____ $ _____

_____ Hrs. Compressor at _____ $ _____

_____ _____ $ _____

_____ Trucking _____ $ _____

_____ Pav't Patch _____ $ _____

_____ _____ $ _____

_____ _____ $ _____

_____ _____ $ _____

_____ _____ $ _____

_____ _____ $ _____

GROVE [redacted] Ave. No. 15

Name of Owner

Labor and Mat'l. Report 19 35, MAY 6

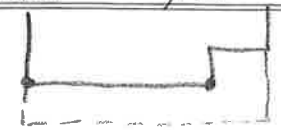

34'7" 29'3"

● Curb Box

6" Main

Elev. of Main at tap 5 1/2'

Gate at ●

● Gate at

● Curb Box

OLD TAP SHUT OFF AT MAIN