LABOR AND MATERIALS

1	Copper ~~Lead~~ Connection 3/4	$ 1.31
1	Curb Cock ~~Valve~~ ~~T. S. & V.~~ 3/4 in.	$ 1.75
1	Service Box Old returned Short 3½x4½ / Long 4½x5½ / Buff. or Rdway	$ 1.60
18	Ft. 3/4 in. Copper / ~~Galv Iron~~ / ~~Cast Iron~~ Pipe at 18	$ 3.24
	Nipples ____ in. at	$
	Bushings ____ to ____ in. at	$
	Red'g / Inc'g Couplings ____ to ____ in. at	$
	Union ____ in. at	$
	Meter ____ in. at	$
	Lead Joints at	$
	Leadite Joints at	$
	Hrs. Foreman at	$
6	Hrs. Chauffeur at 62½¢	$ 3.75
2	Hrs. Tapper at	$ 1.25
11	Hrs. Labor at 45	$ 4.95
	Hrs. Labor at	$
	Hrs. Compressor at	$
	Compensation Ins.	$ .31
	Trucking	$ 1.—
	Builders Use of Water Patch	$ 5.00
	Troy Miller	$
		$
		$
		$
		$ 34.16

23 - - 1940

St. ~~Pl.~~ 26

Harlem Ave. No. 16

Name of Owner

I Rosa

Labor and Mat'l. Report May 20 1940

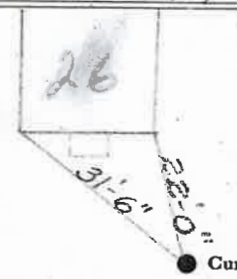

4 Main

Elev. of Main at tap 6½

Gate at ●

● Gate at

TAX ID # 302.20-12-3

● Curb Box

TB