Labor and Materials

1	Copper / Lead	Connection 3/4	$ 1.23
1	Curb	Cock / Valve / T. S. & V. 3/4 in	$ 1.68
1	Service Box / Old returned	~~Short 3½ x 4½~~ / Long 4½ x 5½ / ~~Buff. or Rdway~~	$ 1.75
9	Ft. 3/4 in.	Copper / ~~Galv-Iron~~ / Cast-Iron Pipe at	$ 1.35
	Nipples	in. at	$
1	Bushings 1/2	to 3/4 in. at	$ .04
	Red'g / Inc'g	Conplings to in. at	$
	Union	in. at	$
	Meter	in. at	$
	Lead Joints at		$
	Leadite Joints at		$
	Hrs. Foreman at		$
1½	Hrs. Chauffeur at	62½	$ 94
3	Hrs. Tapper at	7	$ 1.88
3½	Hrs. Labor at	45	$ 1.58
	Hrs. Labor at		$
	Hrs. Compressor at		$
	Compensation Ins.		$ 14
	Trucking		$ 1 —
	Builders Use of Water	No patch (B.D.)	$ —
	Taphy Miller		$
			$
			$
			$
			$ 11.59

8 0 - 1938

~~St.~~ ~~Pl.~~

Harrison Ave. No. 13

Name of Owner

Mack

Labor and Mat'l. Report June 7 1937

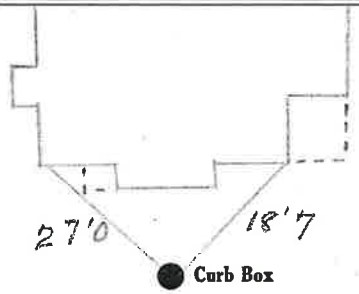

4 Main

Elev. of Main at tap 5

Gate at

Gate at

Curb Box

To be Billed old Shut off