Labor and Materials

1 Copper ~~Lead~~	Connection 3/4	$ 1.23
1 Curb	Cock / ~~Valve~~ / ~~T. S. & V.~~ 3/4 in	$ 1.68
1 Service Box Old returned	Short 3½ x 4½ / Long 4½ x 5½ / ~~Buff. or Rdway~~	$ 1.75
9 Ft. 3/4 in.	Copper / ~~Galv Iron~~ / ~~Cast Iron~~ Pipe at 15	$ 1.35
Nipples in. at		$
1 Bushings 1/2 to 3/4 in. at		$ .04
Red'g / Inc'g Conplings to in. at		$
Union in. at		$
Meter in. at		$
Lead Joints at		$
Leadite Joints at		$
Hrs. Foreman at		$
2½ Hrs. Chauffeur at 62½		$ 1.56
2 Hrs. Tapper at 7		$ 1.25
6½ Hrs. Labor at 45		$ 2.93
Hrs. Labor at		$
Hrs. Compressor at		$
Compensation Ins.		$ .78
Trucking		$ 1.00
Builders Use of Water no patch (B.P.)		$
		$
		$
		$
		$
		$ 12.97

8 1 - 1938

~~St.~~ ~~Pl.~~

Harrison Ave. No. 17+17½

Name of Owner

Davis

Labor and Mat'l. Report June 7 1938

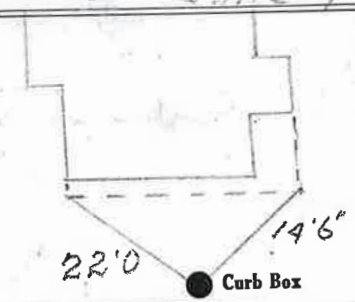

4 Main

Elev. of Main at tap 5

Gate at

Gate at

Curb Box

TAX ID # 302.20-1-3

To be Billed old Shut off