## LABOR AND MATERIALS

| | | | |
|---|---|---|---|
| 1 | Copper ~~Lead~~ Connection | 3/4 | $ 2.29 |
| 1 | Curb { Cock Valve T. S. & V. } | 3/4 in. | $ 2.70 |
| 1 | Service Box Old returned { Short 3½x4½ Long 4½x5½ Buff. or Rdway } | | $ 4.25 |
| 8 | Ft. 3/4 in. { Copper Galv Iron Cast Iron } Pipe at | 35 | $ 2.80 |
| | Nipples ____ in. at | | $ |
| | Bushings ____ to ____ in. at | | $ |
| | Red'g Inc'g } Couplings ____ to ____ in. at | | $ |
| | Union ____ in. at | | $ |
| | Meter ____ in. at | | $ |
| | Lead Joints at | | $ |
| 4 | Leadite Joints at | | $ |
| 4 | Hrs. ~~Foreman~~ at WMM-1-117 | | $ 4.48 |
| | Hrs. Chauffeur at | | $ |
| 8 | Hrs. Tapper at | | $ |
| | Hrs. Labor at | 91 | $ 7.28 |
| | Hrs. Labor at | | $ |
| | Hrs. Compressor at | | $ |
| | Compensation Ins. | | $ .26 |
| | Trucking | | $ 1.00 |
| | Builders Use of Water 13 P. | | $ |
| | Tapped by Miller | | $ |
| | | | $ |
| | | | $ |
| | | | $ |
| | | | $ 25.06 |

✓

~~St.~~
~~Pl.~~
Harrison Ave. No. 25

**Name of Owner**
Theodore J. Krebs

**Labor and Mat'l. Report** June 16 1950

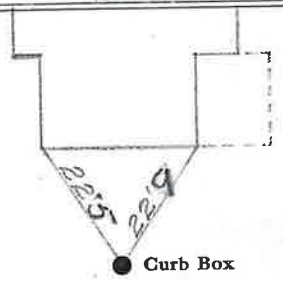


4 Main

Elev. of Main at tap 4'

Gate at ●

● Gate at

● Curb Box

To be Billed ✓