Labor and Materials

1	Copper ~~Lead~~ Connection	3/4	$ 1.23
1	Curb { Cock ~~Valve~~ ~~T. S. & V.~~ }	3/4 in	$ 1.68
1	Service Box Old returned { ~~Short 3½ x 4½~~ Long 4½ x 5½ ~~Buff. or Rdway~~ }		$ 1.75
27 Ft. 3/4 in.	{ Copper ~~Galv Iron~~ ~~Cast Iron~~ } Pipe at	15	$ 4.05
	Nipples in. at		$
	Bushings to in. at		$
	Red'g Inc'g { Couplings to in. at		$
	Union in. at		$
	Meter in. at		$
	Lead Joints at		$
	Leadite Joints at		$
	Hrs. Foreman at		$
2½	Hrs. Chauffeur at	62½	$ 1.56
2	Hrs. Tapper at	62½	$ 1.25
6½	Hrs. Labor at	45	$ 2.93
	Hrs. Labor at		$
	Hrs. Compressor at		$
	Compensation Ins.		$ 18
	Trucking		$ 1.—
	Builders Use of Water no PITCHER		$
	Tapping Miller		$
			$
			$
			$
			$ 15.63

7 7 - 1938

Harrison St. Pl. Ave. No. 2½

Name of Owner

Crandell

Labor and Mat'l. Report June 7 19 38

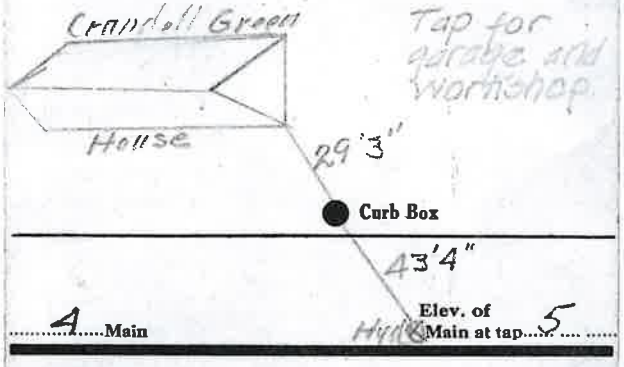

Shut off at Curb
July 12-37 by
Wadleigh & Lareau.

To be Billed old shut off