LABOR AND MATERIALS

1	Copper Lead } Connection	3/4	$ 2.29
1	Curb { Clock Valve T. S. & V. }	3/4 in.	$ 2.70
1	Service box Old returned { Short 3⅛X4½ Long 4⅛X5⅝ Buff or Rdway }		$ 4.25
8	Ft. 3/4 in. { Copper Galv. Iron Cast Iron } Pipe at	35	$ 2.80
	Nipples ... in. at		$
	Bushings ... to ... in. at		$
	Red'g Inc'g } Couplings ... to ... in. at		$
	Union ... in. at		$
	Meter ... in. at		$
	Lead Joints at		$ 1.90
	Compound Joints at		$
2	Hrs. Foreman at Wmmt	1.12	$ 2.24
10	Hrs. Chauffeur at	1.02	$ 10.20
	Hrs. Tapper at		$
6	Hrs. Labor at	91	$ 5.46
	Hrs. Labor at		$
1	Hrs. Compressor at		$ 1.20
	Compensation Ins.		$ .40
	Trucking		$ 1.—
	Builders Use of Water B. P.		$
Tap by Marsuske			$
			$
			$
			$
			$ 32.54

St. ~~Pl.~~ Harrison Ave. No. 29

Name of Owner

Philip Rose

Labor and Mat'l. Report June 17 1950

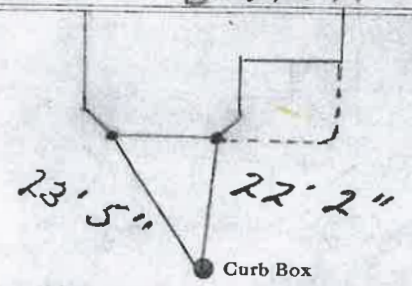

4 Main — Elev. of Main at tap 4½

Gate at ● — ● Gate at

8' to main

● Curb Box

TAX ID # 302.19-17-14

LSM-5C-6-1-48 To be Billed