LABOR AND MATERIALS

1 Copper Lead	Connection 3/4		$ 2.79
1 Curb	Cock ~~Valve~~ T. S. & V.	3/4 in.	$ 2.70
Service box Old returned	Short 3½x4½ Long 4½x5½ Buff or Rdway	Same	$ —
9 Ft. 3/4 in.	Copper G. I. C. I.	Pipe at 35	$ 3.15
Nipples	in. at		$
Bushings	to in. at		$
Red'g Inc'g	Coupl'gs to in. at		$
Union	in. at		$
Meter	in. at		$
Lead Joints at			$
Compound Joints at			$
2 Hrs. Water Maint. Man—1 at		1.12	$ 2.24
2 Hrs. Water Maint. Man—2 at		1.02	$ 1.04
8 Hrs. Labor—	at	91	$ 7.28
Hrs. Labor—	at		$
Hrs. Compressor at			$
Compensation Ins. at $	per C.		$ .24
Trucking			$ 1 —
Pav't Patch	B P.		$
Tap & Nipple			$
			$
			$
O'head			$
			$ 19.94

✓

Harrison St. Pl. Ave. No. 35

Name of Owner

R H Balcom

Labor and Mat'l. Report June 19 1950

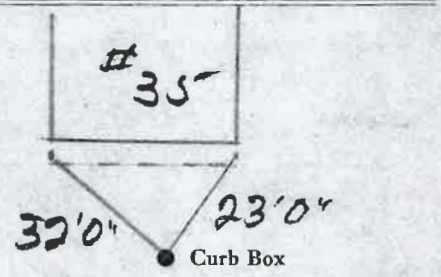

1 Main

Elev. of Main at tap 4½

Gate at ● ● Gate at

TAX ID # 302.19-17-11

● Curb Box

LSM-5C 10-21-49

To the Billed