LABOR AND MATERIALS

1	Copper Lead	Connection 3/4	$	2.29
1	Curb { Clock Valve T. S. & V. }	3/4 in.	$	2.70
	Service box Old returned { Short 3½X4½ Long 4½X5½ Buff or Rdway }		$	—
8	Ft. 3/4 in. { Copper Galv. Iron Cast Iron }	Pipe at 35	$	2.80
	Nipples in. at		$	
	Bushings to in. at		$	
	Red'g Inc'g { Couplings to in. at		$	
	Union in. at		$	
	Meter in. at		$	
	Lead Joints at		$	
	Compound Joints at		$	
4	Hrs. ~~Foreman~~ at Wmm	1.12	$	4.48
2	Hrs. ~~Chauffeur~~ at	1.02	$	2.04
1	Hrs. Tapper at		$	
6	Hrs. Labor at	91	$	5.46
	Hrs. Labor at		$	
	Hrs. Compressor at		$	
	Compensation Ins.		$	.27
	Trucking		$	1.—
	Builders Use of Water B P.		$	
			$	
			$	
			$	
			$	21.04

✓

~~St.~~ ~~Pl.~~ Harrison Ave Ave. No. 43

Name of Owner

George Beaton

Labor and Mat'l. Report June 22 1950

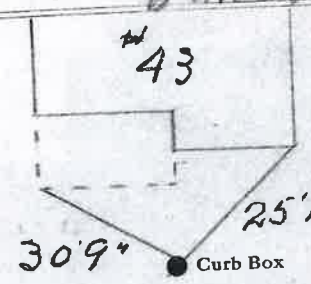

4 Main — Elev. of Main at tap 4

Gate at ● ● Gate at

● Curb Box

LSM-5C-6-1-45

To be Billed